

Exhibit 4- Boundary area discrepancies with AT&T
attempts to resolve and map that support
our boundaries.



64 N Clark • Sullivan, MO • 63080 • 573-468-1223 • 573-468-5440 • 800-392-8070

July 12, 2014

Ms. Chelsea Fallon
Federal Communication Commission
Via Email: Chelsea.Fallon@fcc.gov

RE: Study Area Boundary Discrepancy with AT&T – Process for conforming data to
eliminate overlaps

Dear Ms. Fallon,

We are in receipt for your correspondence dated June 20, 2014, regarding study area boundary overlaps between our Company and AT&T. Please be advised that on March 14, 2014 we responded to AT&T in regards to their boundary map discrepancies and believe our maps are accurate in all aspects and that AT&T encroaches on Fidelity's incumbent service areas.

As showed in the attached information submitted to AT&T on March 14 we have followed the FCC's order to resolve mapping inconsistencies and pursuant to your letter have again made a request to AT&T to resubmit and recertify the boundaries to the FCC.

If you have any questions or concerns, feel free to contact me at (573) 468-1218 or carla.cooper@fidelitycommunications.com.

Respectfully,

FIDELITY COMMUNICATIONS CO.

A handwritten signature in blue ink that reads 'Carla Cooper'.

Carla Cooper
Director of Revenue Accounting

Enclosure
CC: john.emmett@fcc.gov



64 N Clark • Sullivan, MO • 63080 • 573-468-8081 • 573-468-5440 • 800-392-8070

July 1, 2014

Gregory Wagner
AT&T
Via Email: gw5604@att.com

RE: Study area discrepancy boundary with AT&T

Dear Mr. Wagner,

We recently received correspondence from the FCC indicating that there continues to be a study area boundary overlap with AT&T and our Company. Fidelity responded to AT&T's claim on March 14 that we had reviewed the maps submitted by AT&T as well as the exchange boundary maps approved by and on file with the Missouri Public Service Commission for both Fidelity and AT&T (collectively, the "PSC Maps"), and Fidelity agrees that there are areas of overlap; however, Fidelity disagrees that its service areas encroach upon AT&T's incumbent service territories. Rather, the opposite is the case. That is, AT&T encroaches on Fidelity's incumbent service areas).

We furnished copies of the PSC Maps, as well as a map showing those areas where AT&T's service areas extend into Fidelity's local exchange service boundaries.

Pursuant to the FCC's order establishing procedures to resolve mapping inconsistencies, Fidelity requested AT&T review these PSC Maps and study area boundaries as soon as possible. If AT&T agreed that the boundary maps overlap into Fidelity's authorized exchange service areas, then Fidelity requests that AT&T resubmit and recertify the boundaries by the FCC's March 17, 2014 deadline.

Given AT&T's failure to reply, we can only assume that if a boundary line discrepancy exists, the error lies with AT&T and its boundary maps. We will be notifying the FCC accordingly, and request that you take the necessary action to correct AT&T's boundary maps filed with the FCC. If you have any questions regarding this matter, please contact me at your convenience.

If you have any questions or concerns, feel free to contact me at (573) 468-1218 or carla.cooper@fidelitycommunications.com.

Respectfully,

FIDELITY COMMUNICATIONS CO.

A handwritten signature in blue ink that reads 'Carla Cooper'.

Carla Cooper
Director of Revenue Accounting



64 N Clark • Sullivan, MO • 63080 • 573-468-1223 • 573-468-5440 • 800-392-8070

March 14, 2014

Mr. Gregory Wagner
AT&T
Via Email: gw5604@att.com

RE: Study Area Boundary Discrepancy with AT&T

Dear Mr. Wagner,

This letter responds to your email dated February 2, 2014, in which you claim that Fidelity Telephone Co. ("Fidelity") service boundaries overlap AT&T incumbent service areas.

Fidelity has reviewed the maps submitted by AT&T as well as the exchange boundary maps approved by and on file with the Missouri Public Service Commission for both Fidelity and AT&T (collectively, the "PSC Maps"), and Fidelity agrees that there are areas of overlap; however, Fidelity disagrees that its service areas encroach upon AT&T's incumbent service territories. Rather, the opposite is the case. That is, AT&T encroaches on Fidelity's incumbent service areas).

I have enclosed for your convenience a copy of the PSC Maps, as well as a map showing those areas where AT&T's service area extend into Fidelity's local exchange service boundaries.

Pursuant to the FCC's order establishing procedures to resolve mapping inconsistencies, Fidelity requests that AT&T review these PSC Maps and study area boundaries as soon as possible. If AT&T agrees that the boundary maps overlap into Fidelity's authorized exchange service areas, then Fidelity requests that AT&T resubmit and recertify the boundaries by the FCC's March 17, 2014 deadline.

If you have any questions or concerns, feel free to contact me at (573) 468-1218 or carla.cooper@fidelitycommunications.com.

Respectfully,


FIDELITY COMMUNICATIONS CO.

A handwritten signature in blue ink that reads "Carla Cooper".

Carla Cooper
Director of Revenue Accounting

CC/jlt
Enclosure

ATT Overlap Challenge Area

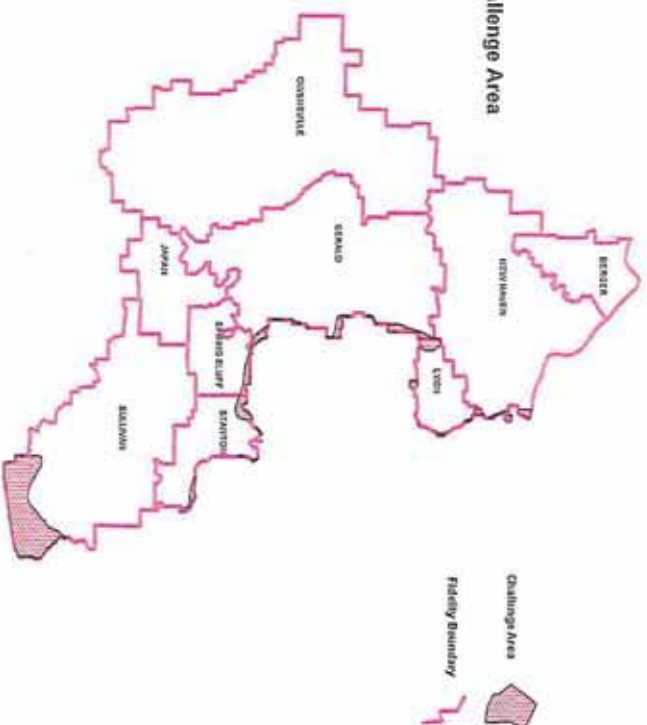

67. *How would "What's a
the" be used "What's a
the" be used "What's a*

OK



5


NO SUPPLEMENT TO THIS TARIFF WILL
BE ISSUED EXCEPT FOR THE PURPOSE OF
CANCELING THIS TARIFF.

P. S. C. Mo. No. 17 **OK**

Washington, Missouri

7th REVISED SHEET 3
REPLACING 6th REVISED SHEET 3

EXCHANGE AREA MAP

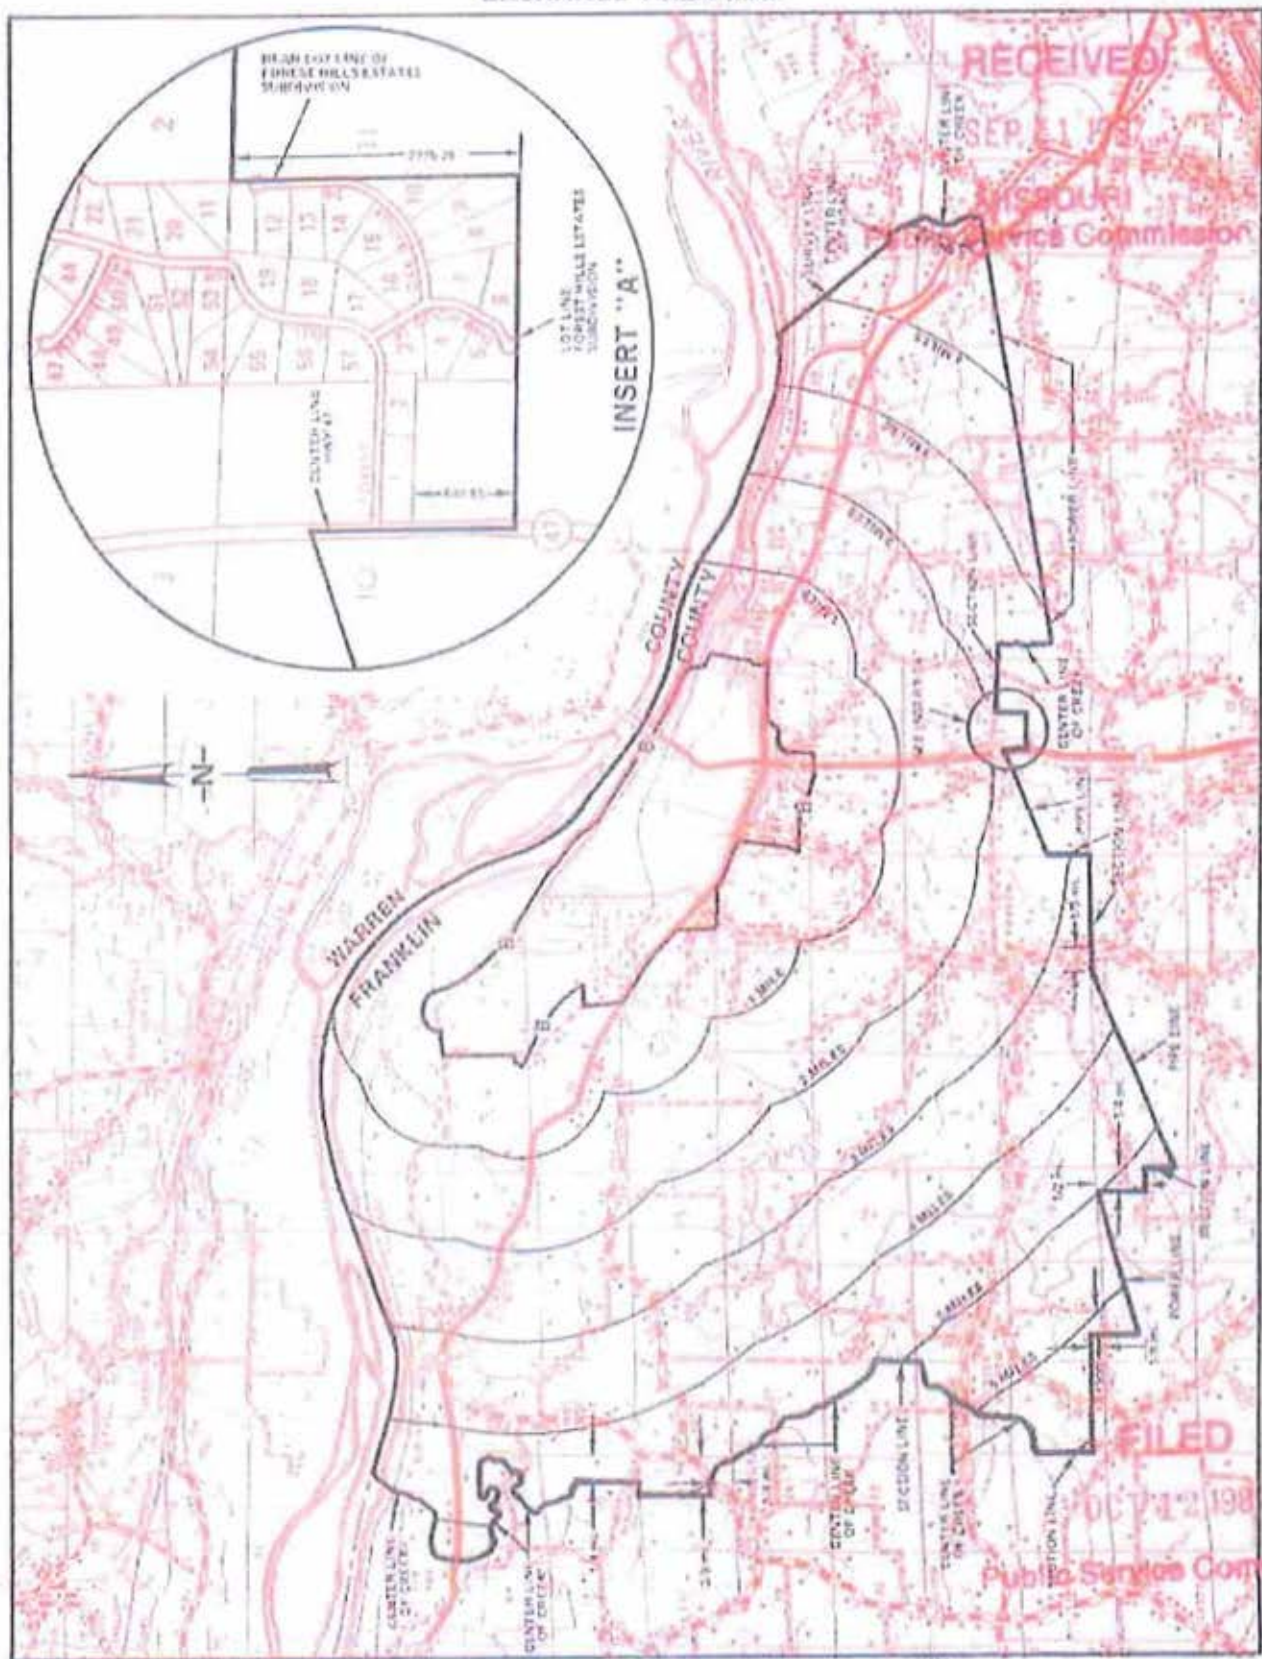

SEP 11 1987

By R. D. BARRON, President, Missouri Division
Southwestern Bell Telephone Company


OCT 12 1987

OK

NO SUPPLEMENT TO THIS TARIFF WILL
BE ISSUED EXCEPT FOR THE PURPOSE OF
CANCELLING THIS TARIFF.

P. S. C. MO. No. 17
EXCHANGE AREA MAP

St. Clair, Missouri
2246 REVISED SHEET 2
REPLACING 2196 REVISED SHEET 2

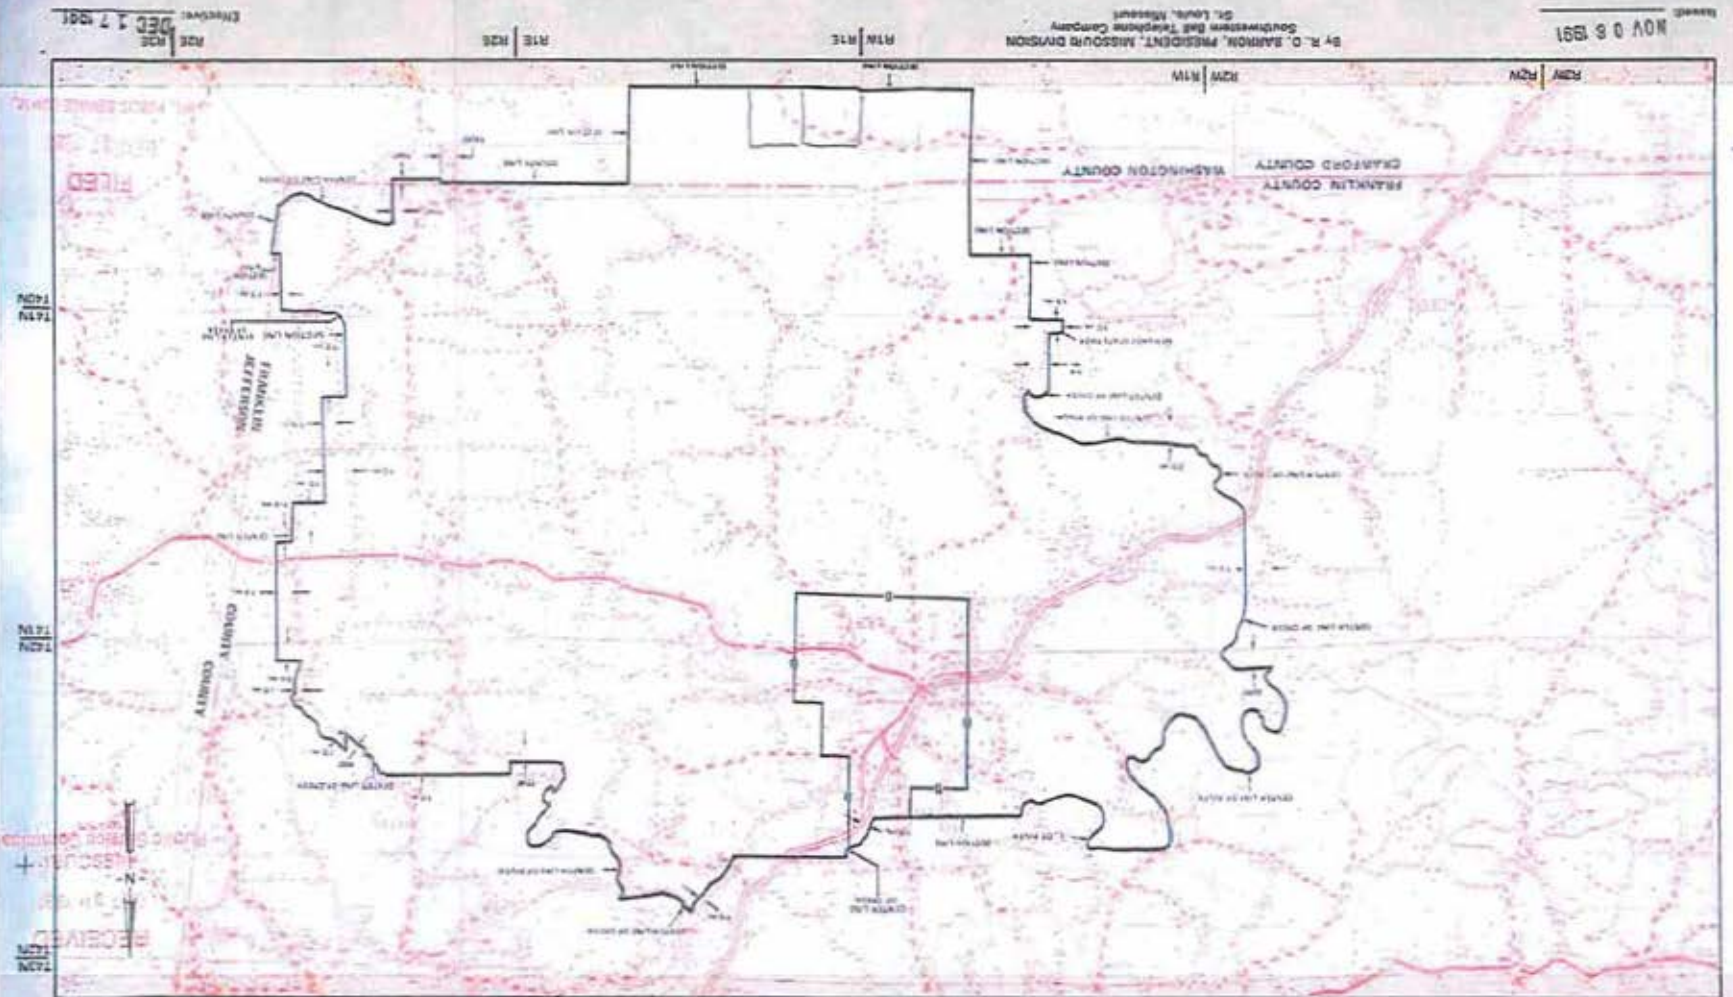

RECEIVED
DEC 17 1991


NO SUPPLEMENT TO THIS TARIFF WILL
BE ISSUED EXCEPT FOR THE PURPOSE OF
CANCELING THIS TARIFF.

P. S. C. Mo. No. 17
EXCHANGE AREA MAP

Richwoods, Missouri

5th REVISED SHEET 3
REPLACING 4th REVISED SHEET 3

MAY 1 1977

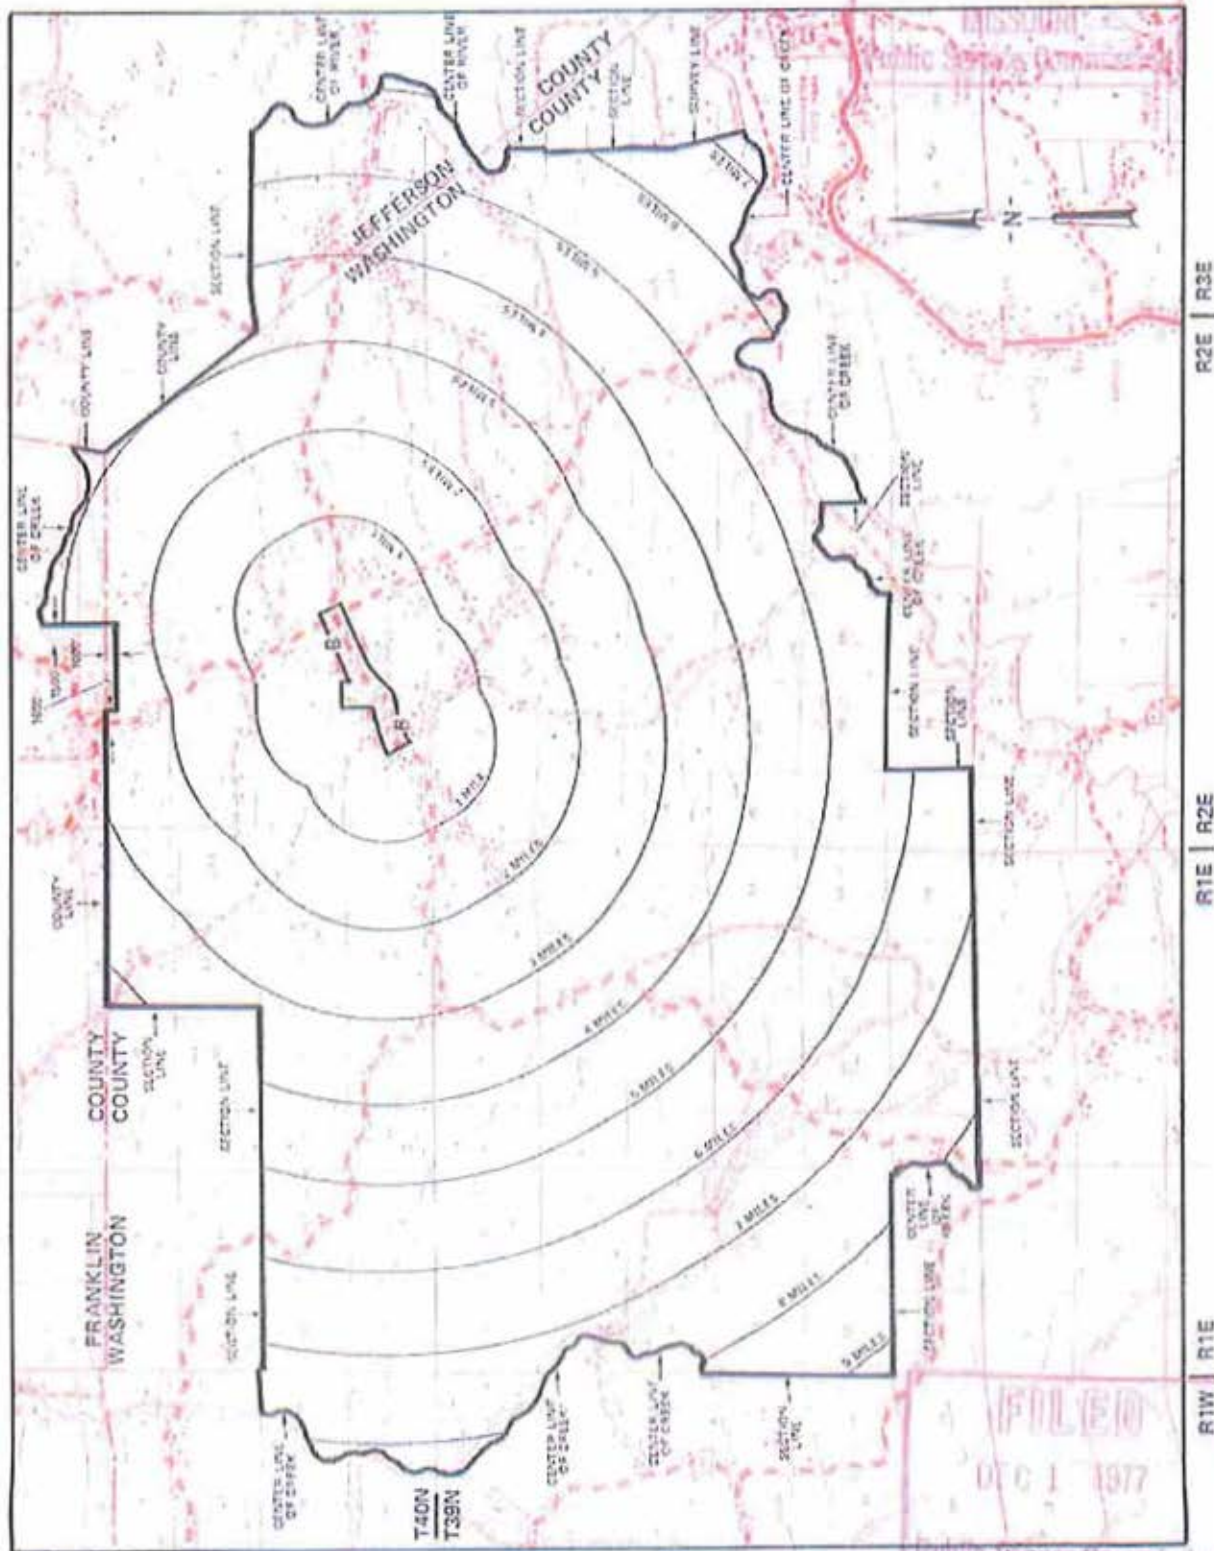

By R. R. SHOCKLEY, Vice President, Missouri
Southwestern Bell Telephone
St. Louis, Missouri

Issued: MAY 23 1977


Effective: DEC 1 1977

FORM NO.13 P.S.C. MO. No. 1 5th (indicated) Sheet No. 4
(revised)
Cancelling P.S.C. MO. No. 1 4th (indicated) Sheet No. 4
(revised)

Fidelity Telephone Company For Sullivan, Missouri
Name of Issuing Corporation Community, Town or City
Franklin, Crawford, & Washington
Counties **RECEIVED**

EXCHANGE AREA MAP

MAR 21 1994

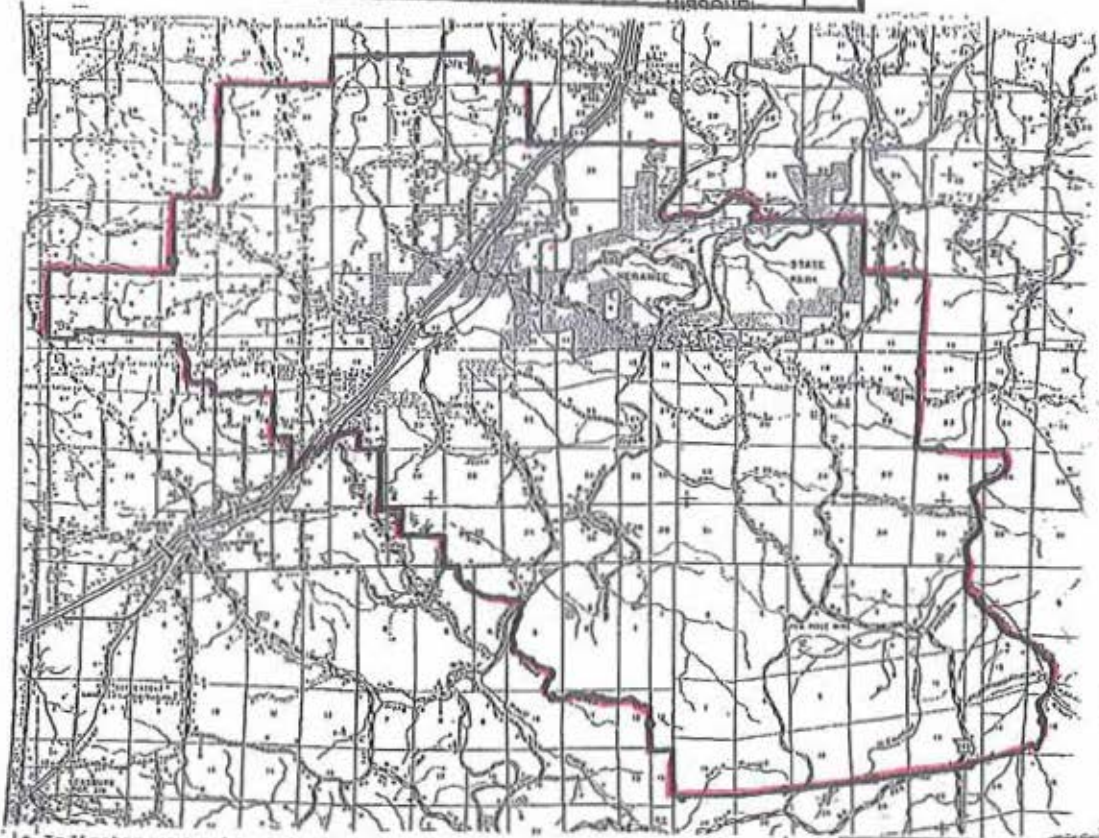

* Indicates new rate or text
+ Indicates change

MISSOURI
Public Service Commission
DATE OF ISSUE March 21, 1994 DATE EFFECTIVE April 20, 1994
month day year month day year
ISSUED BY Ken Matzdorff, Asst. V.P. Revenues, 64 N. Clark Sullivan, MO
name of officer title address

FORM NO. 13 P.S.C.M.O. No. 1 1st {Revised} SHEET No. 4

Cancelling P.S.C.M.O. No. 1 2nd {Revised} SHEET No. 4

FIDELITY TELEPHONE COMPANY
Name of Issuing Corporation

For New Haven, Missouri
Community, Town or City
Franklin and Gasconade Counties

EXCHANGE AREA MAP



DATE OF ISSUE May 1, 1977 DATE EFFECTIVE June 1, 1977
month day year month day year

ISSUED BY Evan R. Gopsey President Sullivan, MO
name of officer title address

For Lyon, Missouri
Community, Town or City
Franklin County

DATE OF ISSUE May 1, 1977 DATE EFFECTIVE June 1, 1977
month day year month day year

ISSUED BY Evan R. Copsey President Sullivan, MO
name of officer title address

City Telephone Company


PSC MO. NO. 1

Original Sheet No. 3.1

EXCHANGE AREA MAP FOR GERALD, MO.

Missouri Public
Service Commission

REC'D DEC 01 1998

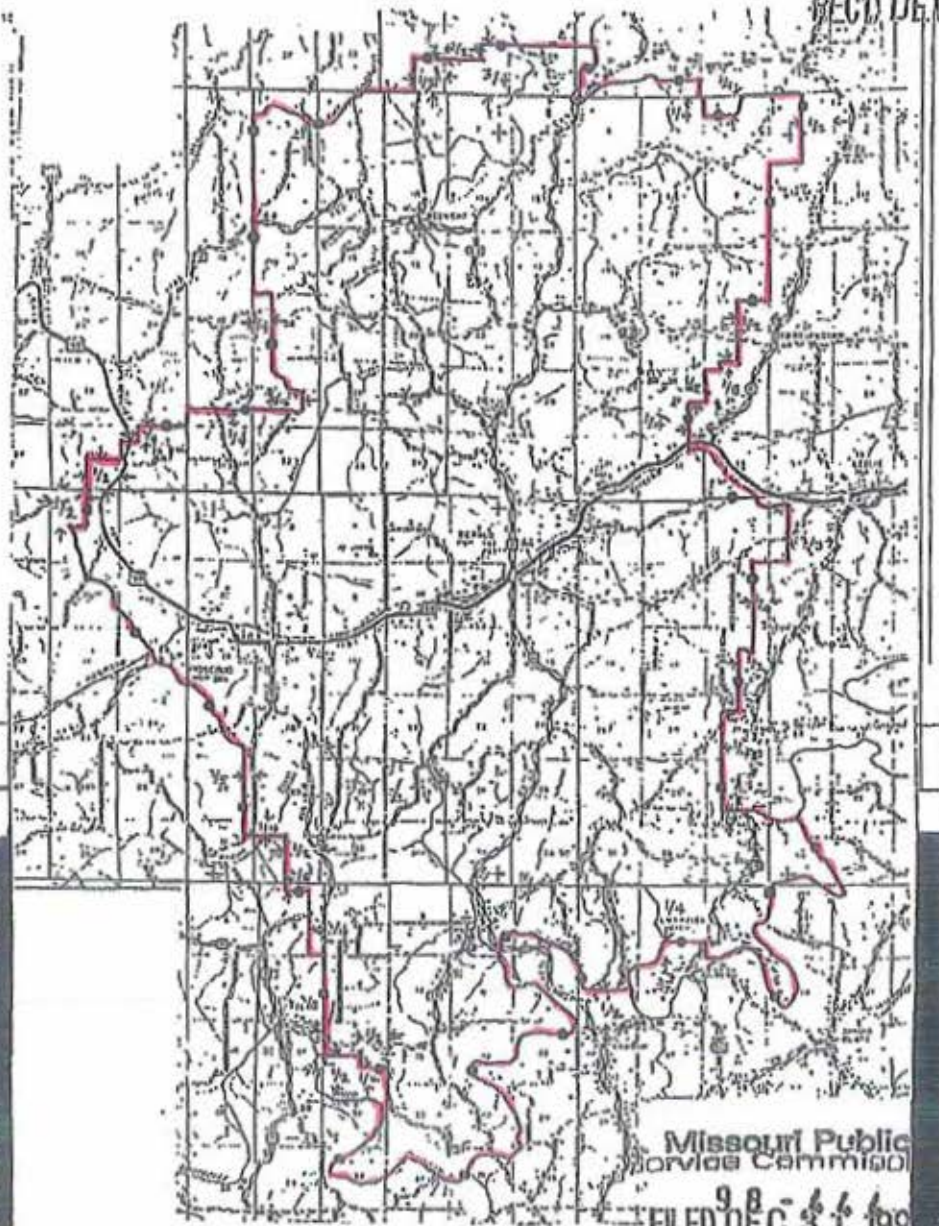

Missouri Public
Service Commission

FILED DEC 31 1998


Issued: December 1, 1998

Issuing Officer:
John Davis
64 North Clark
Sullivan, Missouri 63080

Effective: December 31, 1998

FORM NO. 13 P.S.C.MO. No. 1 2nd ~~Original~~ SHEET No. 4
(Revised)
Cancelling P.S.C.MO. No. 1 1st ~~Original~~ SHEET No. 4
(Revised)

FIDELITY TELEPHONE COMPANY For Spring Bluff, Missouri
Name of Issuing Corporation Community, Town or City
Franklin County

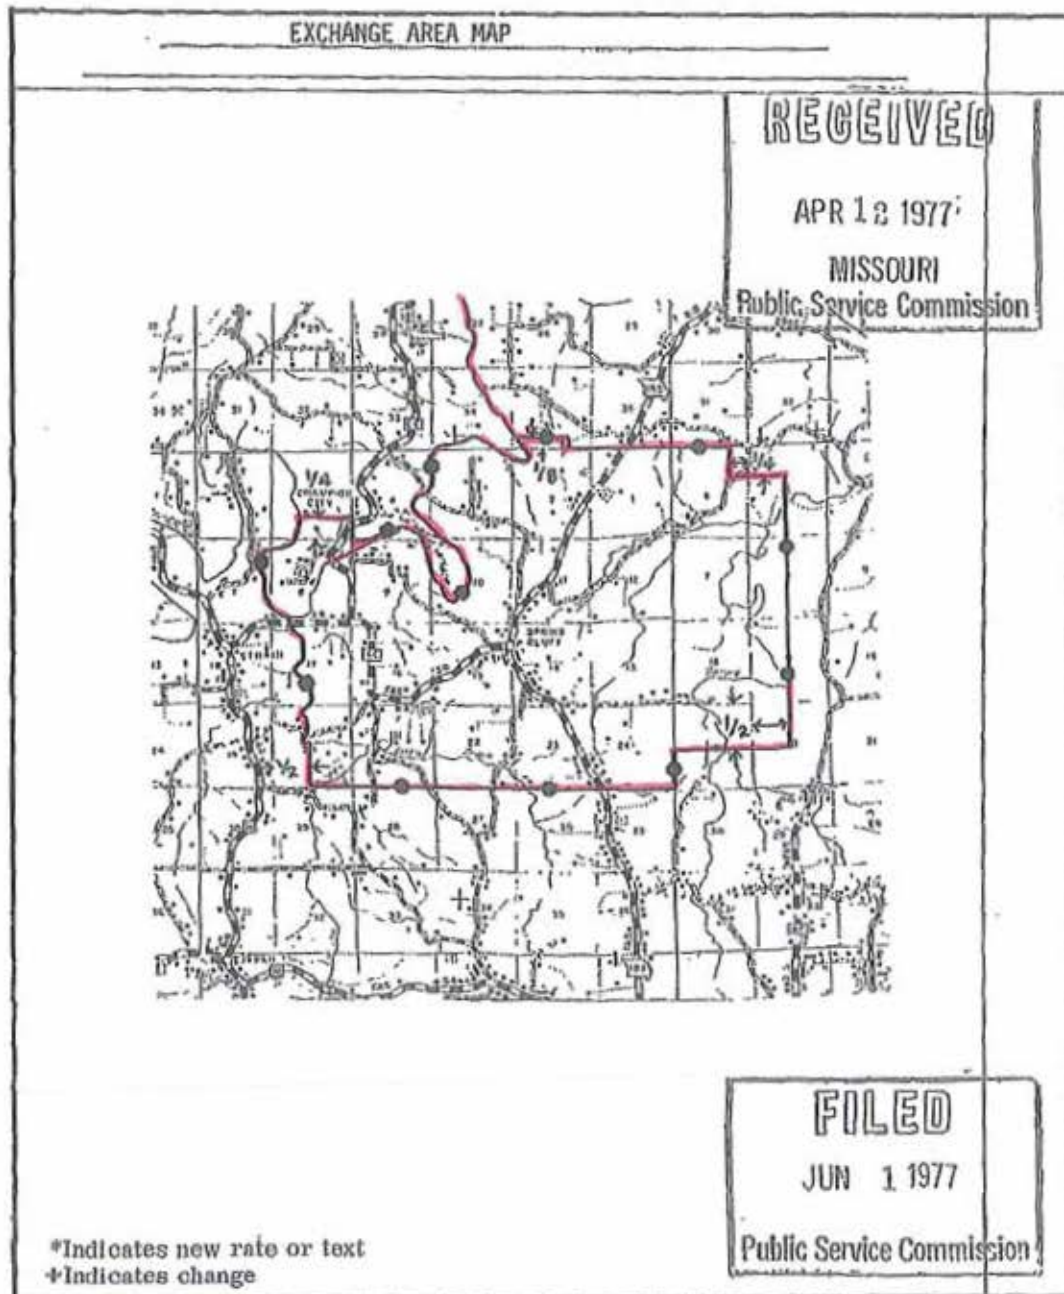

DATE OF ISSUE May 1, 1977 DATE EFFECTIVE June 1, 1977
month day year month day year
ISSUED BY Evan R. Copsey President Sullivan, MO
name of officer title address

FORM NO. 13 P.S.C.MO. No. 1 4th ~~Original~~ Revised SHEET No. 4

Cancelling P.S.C.MO. No. 1 3rd ~~Original~~ Revised SHEET No. 4

FIDELITY TELEPHONE COMPANY

Stanton, Missouri

Name of Issuing Corporation


For

Community, Town or City

Franklin

County

RECEIVED

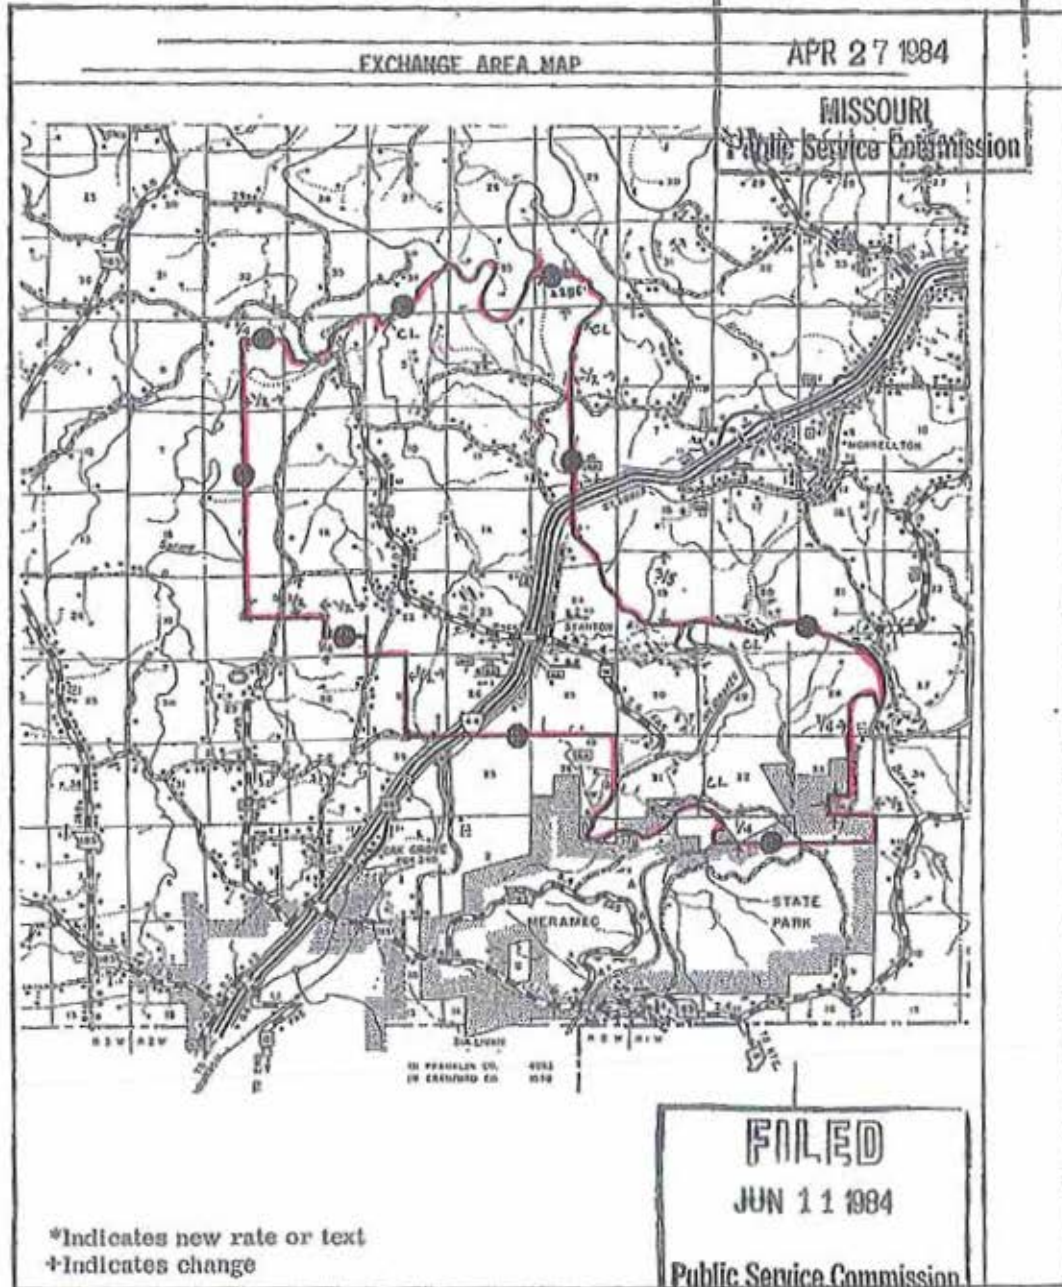

DATE OF ISSUE May 10, 1984 DATE EFFECTIVE June 11, 1984
month day year month day year

ISSUED BY Evan R. Copsey President Sullivan, MO
name of officer title address